THIS DRAWING IS UNPUBLISHED. RELEASED FOR PUBLICATION .19 .
© COPYRIGHT 19 BY AMP INCORPORATED. ALL RIGHTS RESERVED.

LOC	DIST
AP	-

REVISIONS

P	LTR	DESCRIPTION	DATE	DWN	APVD
	B	REVISED BY EC LB00-0194-02	07OCT2002	H.C	WLS
	C	REVISED BY ECO 07-015096	20SEP2007	H.C	WLS
	C1	REVISED PER ECO-09-026346	26NOV09	KK	AEG

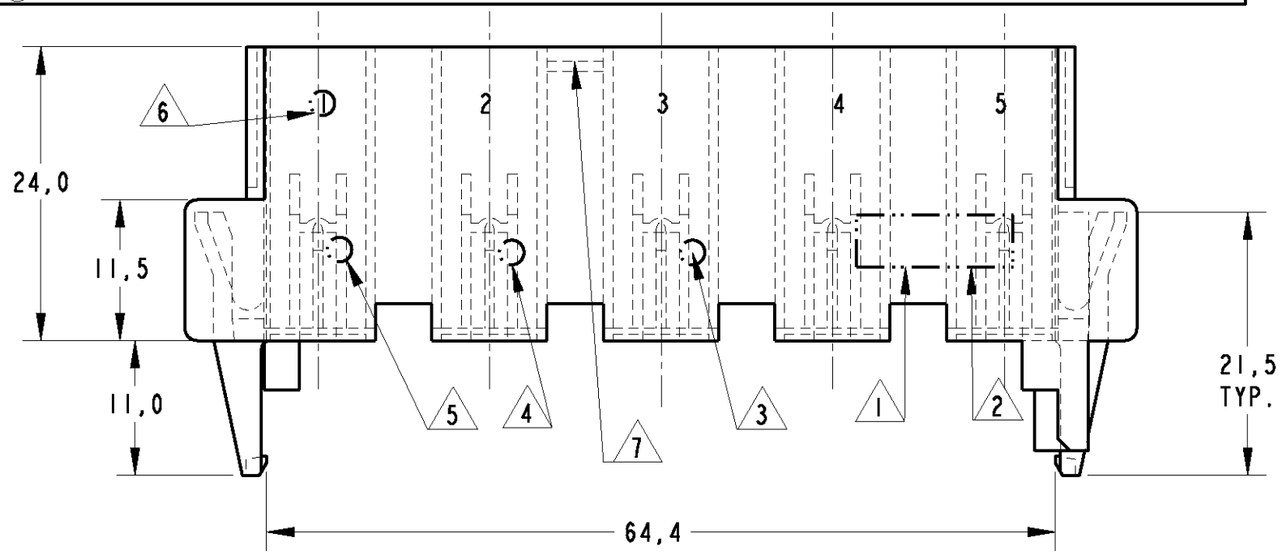

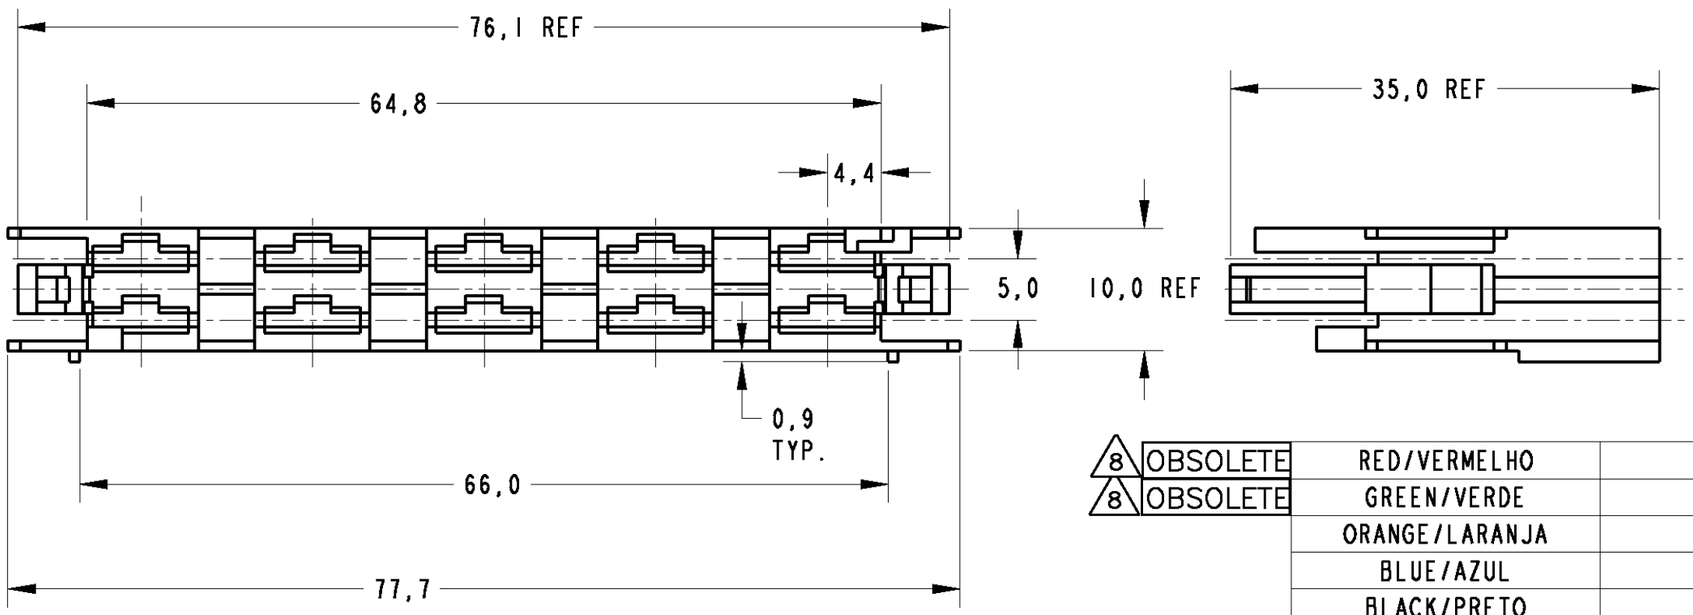

GRAVAÇÃO MARKING	
LOGOTIPO AMP / AMP LOGO	1
CÓDIGO PAÍS PRODUTOR / MANUFACTURER COUNTRY CODE	2
NOMENCLATURA MATERIAL / MATERIAL NOMENCLATURE	3
NÚMERO CAVIDADE / CAVITY NUMBER	5
IDENTIFICAÇÃO CIRCUITO / CIRCUIT IDENTIFICATION	6
REV.+ LETRA REV.DES. / REV.+ DWG REV.LETTER	4
MANUFACTURING DATE / DATA DE FABRICAÇÃO	7

	FINISH	MATERIAL	PART NUMBER
8 OBSOLETE	RED/VERMELHO	PA 6.6 V2	~~493716-6~~
8 OBSOLETE	GREEN/VERDE	PA 6.6 V2	~~493716-5~~
	ORANGE/LARANJA	PA 6.6 V2	493716-4
	BLUE/AZUL	PA 6.6 V2	493716-3
	BLACK/PRETO	PA 6.6 V2	493716-2
	WHITE/BRANCO	PA 6.6 V2	493716-1

8 **OBSOLETE PARTS: OBSOLETE CIS STREAMLINING PER D.RENAUD/D.SINISI**

THIS DRAWING IS A CONTROLLED DOCUMENT FOR AMP INCORPORATED. IT IS SUBJECT TO CHANGE AND THE CONTROLLING ENGINEERING ORGANIZATION SHOULD BE CONTACTED FOR THE LATEST REVISION.

DIMENSIONS: mm

TOLERANCES UNLESS OTHERWISE SPECIFIED:
0 PLC ±-
1 PLC ±0,3
2 PLC ±0,2
3 PLC ±-
4 PLC ±-
ANGLES ±1°

MATERIAL: SEE TABLE -
FINISH: SEE TABLE -

DWN H.C.CANTERI 28DEC98
CHK M.F.GUIMARÃES 28DEC98
APVD H.B.VASCONCELOS 28DEC98
PRODUCT SPEC -
APPLICATION SPEC -
WEIGHT -

AMP — AMP do Brasil LTDA. São Paulo , Brasil

NAME: - 10 POS. FASTIN-ON HSG. -

SIZE	CAGE CODE	DRAWING NO	RESTRICTED TO
A3	00779	C-493716	-

CUSTOMER DRAWING | SCALE 2:1 | SHEET 1 OF 1 | REV C1